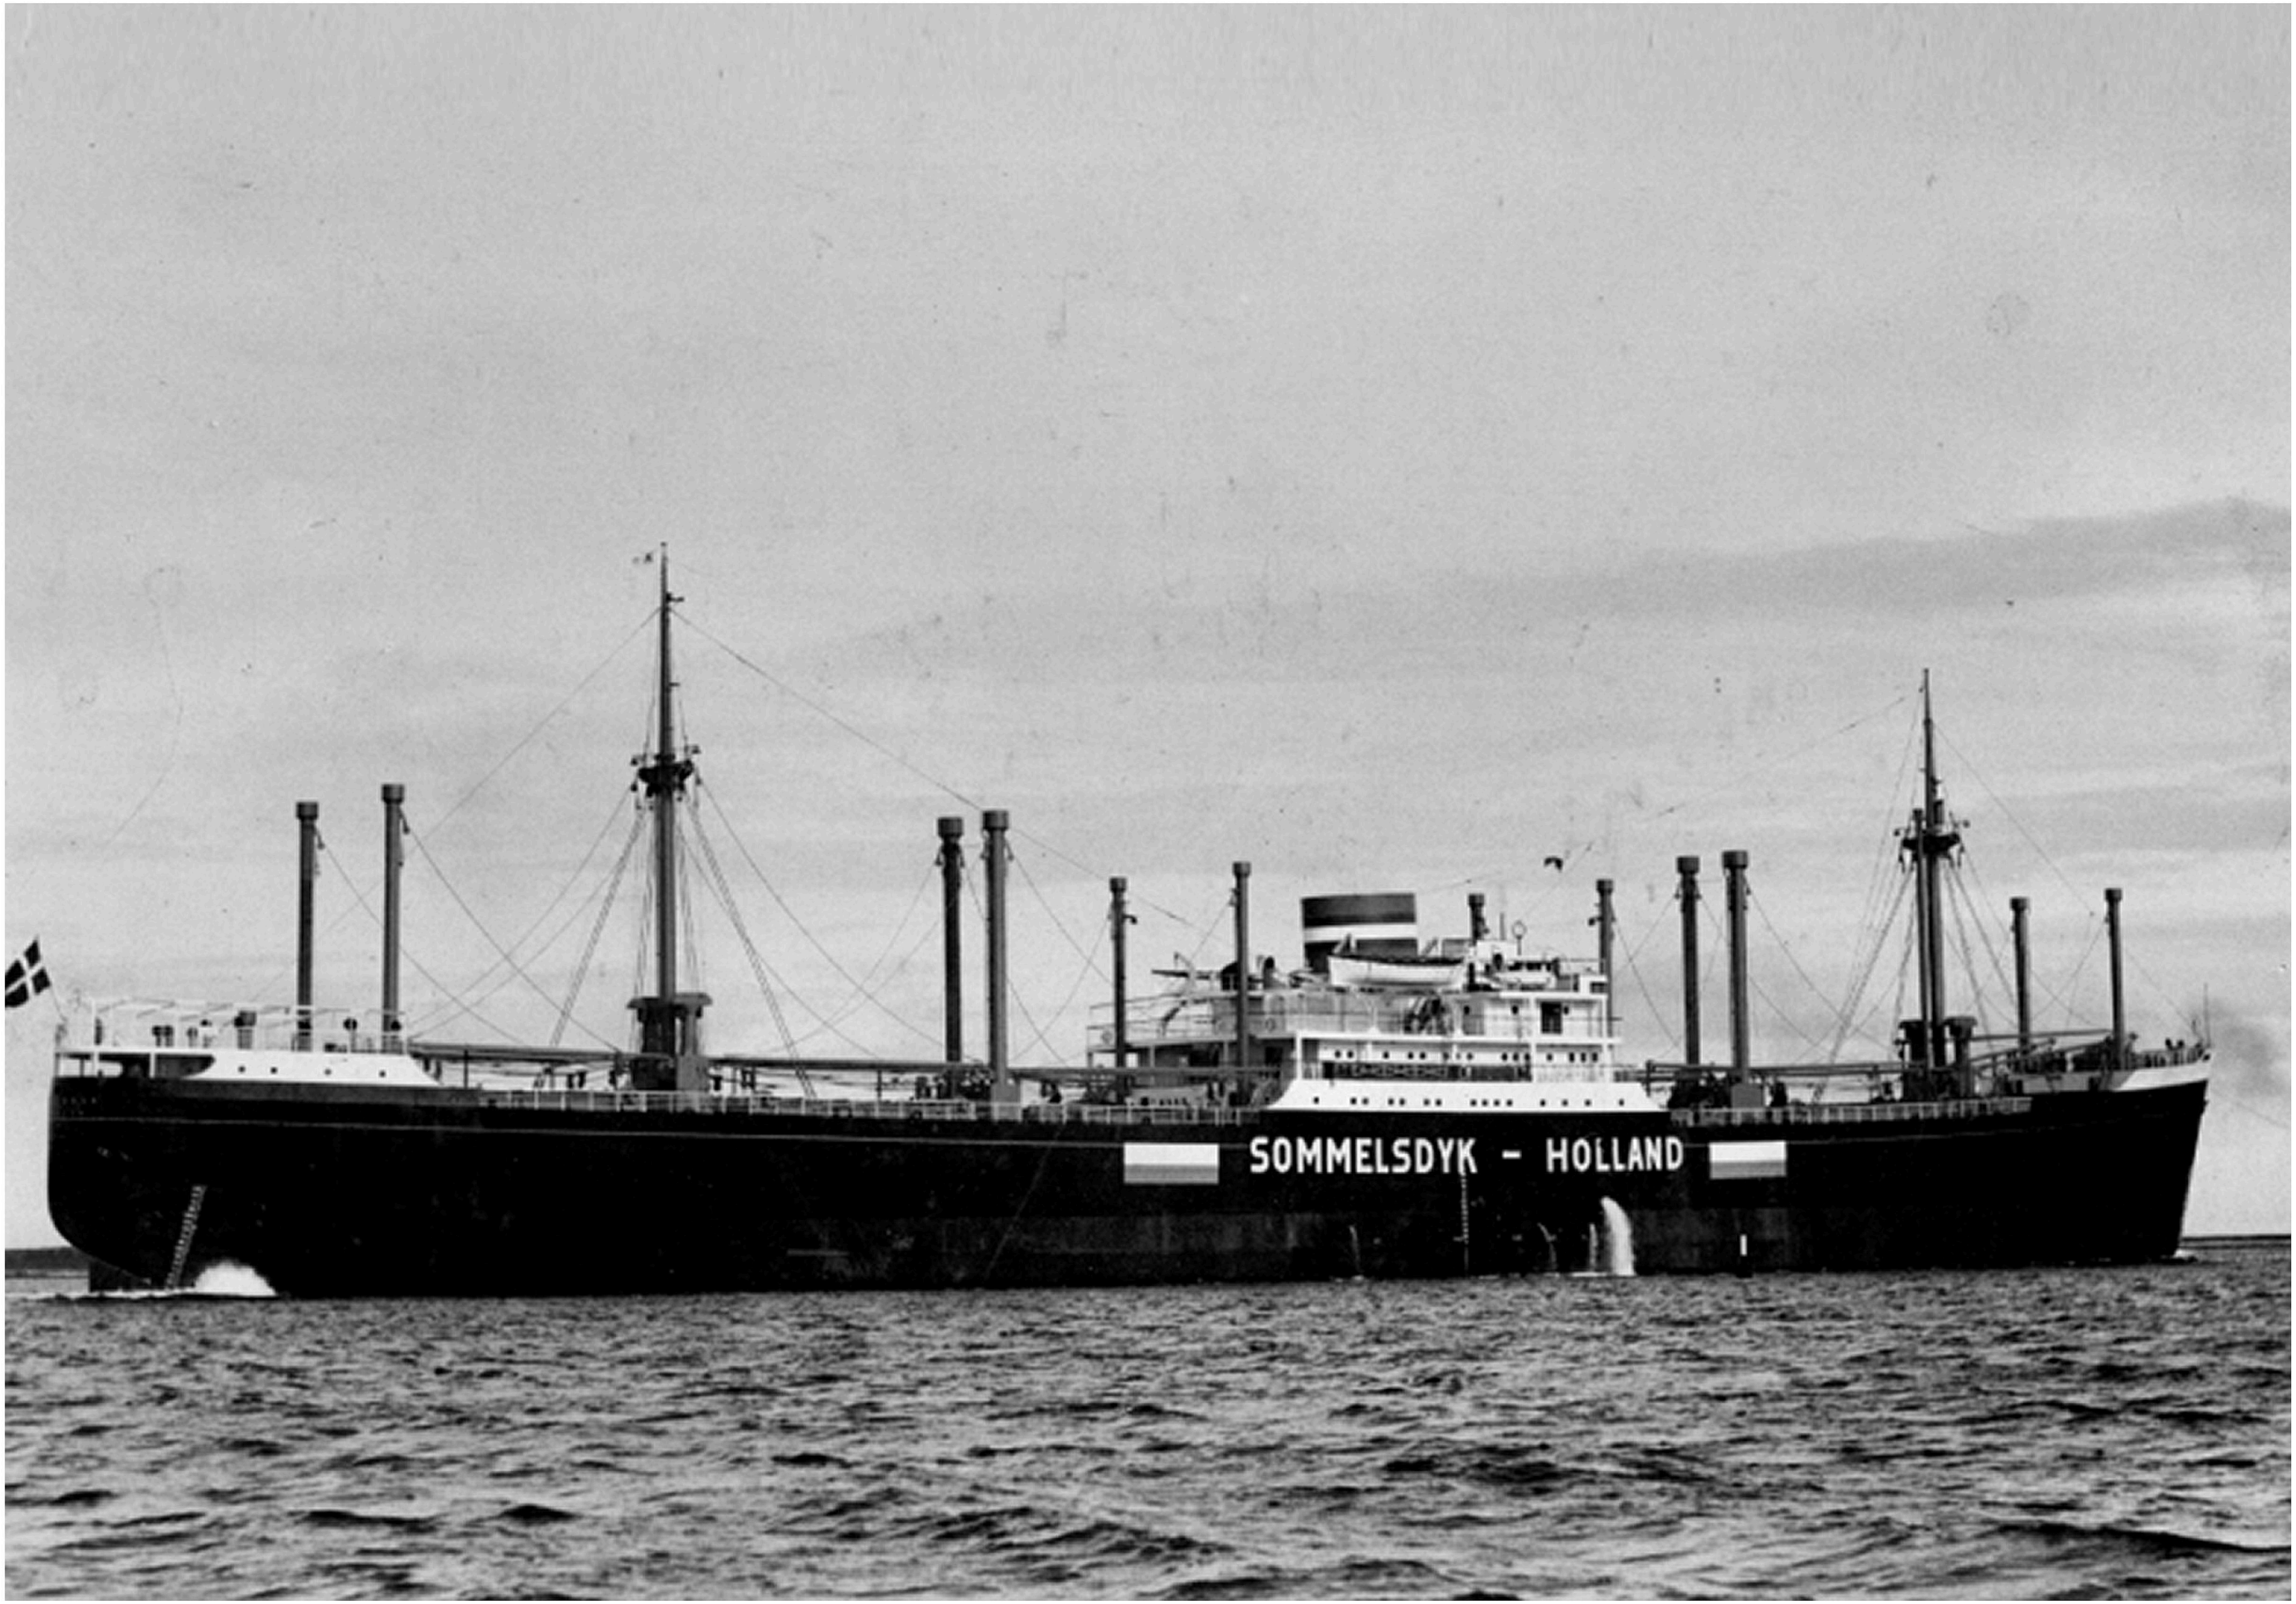
SOMMELSDYK - HOLLAND

00 - cover photo

SOMMELSDYK - HOLLAND

01 - cover sheet profile & deck plan

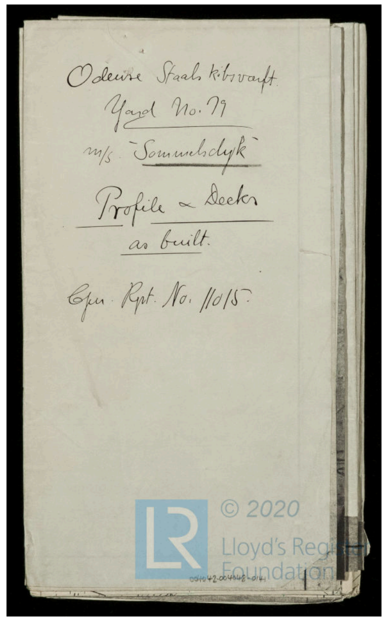
Odense Staalskibsvaerft.
Yard No. 79
m/s "Sommelsdyk"
Profile & Decks
as built.

Gen. Rpt. No. 11015.

© 2020 Lloyd's Register Foundation

02 - profile & deck plan

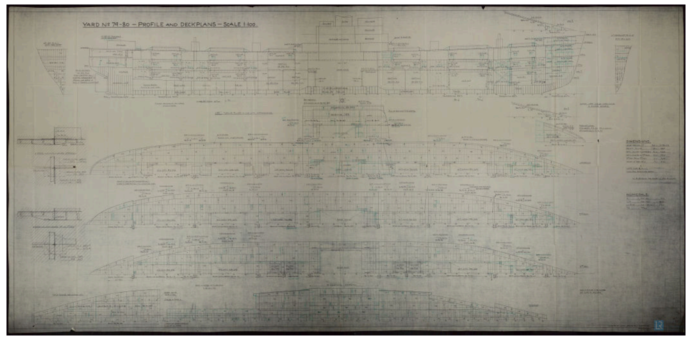

03 - cover sheet midship section

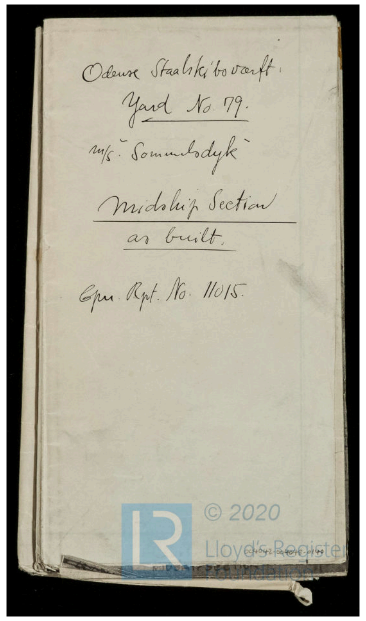
Odense Staalskibsvaerft.
Yard No. 79.
m/s. "Sommelsdyk"
Midship Section
as built.

Gen. Rpt. No. 11015.

© 2020 Lloyd's Register Foundation

04 - midship section

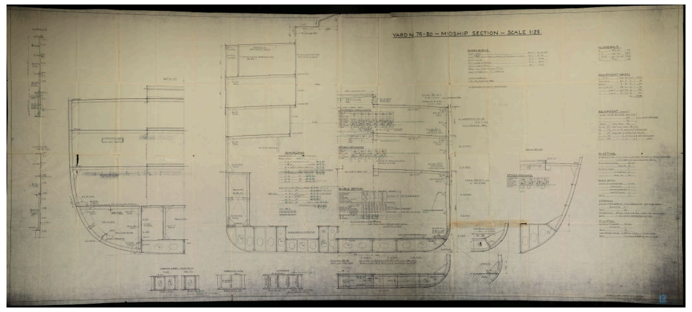

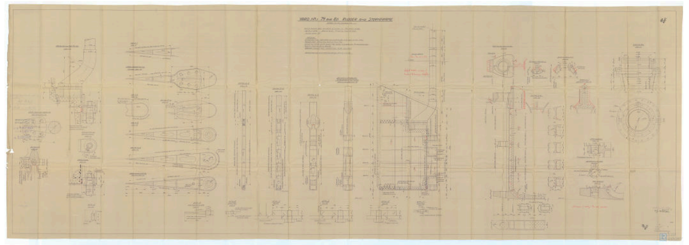05 - stern & rudder frame